

# NOAO

## ENGINEERING CHANGE ORDER

BOARD NAME <u>Torrent LCB</u>	ECO# <b>TRNT-0003</b>	DATE <u>APRIL 2009</u>
BRD SERL# <u>ALL</u> REV _____	ART# _____	
PN# _____ REV _____	_____ REV _____	_____ REV _____
ASBLY# <u>TRNT-EL-04-0004</u> REV <u>OD</u>	PCB# _____ REV _____	_____ REV _____
BOM# _____ REV _____	SCH# <u>TRNT-EL-04-2001</u> REV <u>OD</u>	_____ REV _____
COGNIZANT ENGNR <u>Peter Moore/ Dave Sawyer</u>	CHARGE# _____	

**REASON FOR MODIFICATION:**

Installation of parts not in stock at the time of build stabilize clock signals, ability to ground test probes

DRAWINGS AFFECTED:	NEW REV
TRNT-EL-04-2001 rOD	-1.0
TRNT-EL-04-0001 rOD	-1.0

**DESCRIPTION OF MODIFICATION:**

Figure 1 – overall view, high lighted components top & bottom.

**1. TOP Side Install & wire adds:**


- 1.1 D1 item 91, (Fig 2)
- 1.2 TP13 & TP14: Item 89 (Fig 2)
- 1.3 U20 & U37 modifications (rework done by contractor) (Fig 3, 3a, 3b)

**2. Bottom Side Install & wire adds:**

- 2.1 Add Low pass filter (U28-32 to 5.6nF to GND) (U28-32 to 10nF cap via a 1% 3.65K resistor to ground) component adds are on the bottom of the board see figure 4. C255, C254, R119 should be glued to the board. Abut and solder one terminal of R119 & C254 together at location shown, add wire to the opposite terminal of R119 to ground via (shown in Fig 4). Add wire from opposite terminal of C254 to TP7. C255 – wire add 1 terminal to TP7 and the other terminal to ground via (shown in Fig. 4).
- 2.2 Install L8, Item #32 (Fig 5)
- 2.3 RN1, RN2, RN3, Item 74 (Fig 5)
- 2.4 J13, Item 88 & TP12 Item 89 (Fig 5)
- 2.5 Install L10, Item #33 (Fig 6)
- 2.6 C239, Item 23 (Fig 6)
- 2.7 J10 (2 parts), Item 76 & 77 (Fig 6)
- 2.8 Ground test point TP11 Item 89 (Fig 6)
- 2.9 remove R66, tie U27-N22 to ground (wire add see Fig 7)


FIGURE 1

OD	INITIAL RELEASE		24MAR09	DMS
-1	see ECO for details	TRNT-0003	27JUL09	DMS

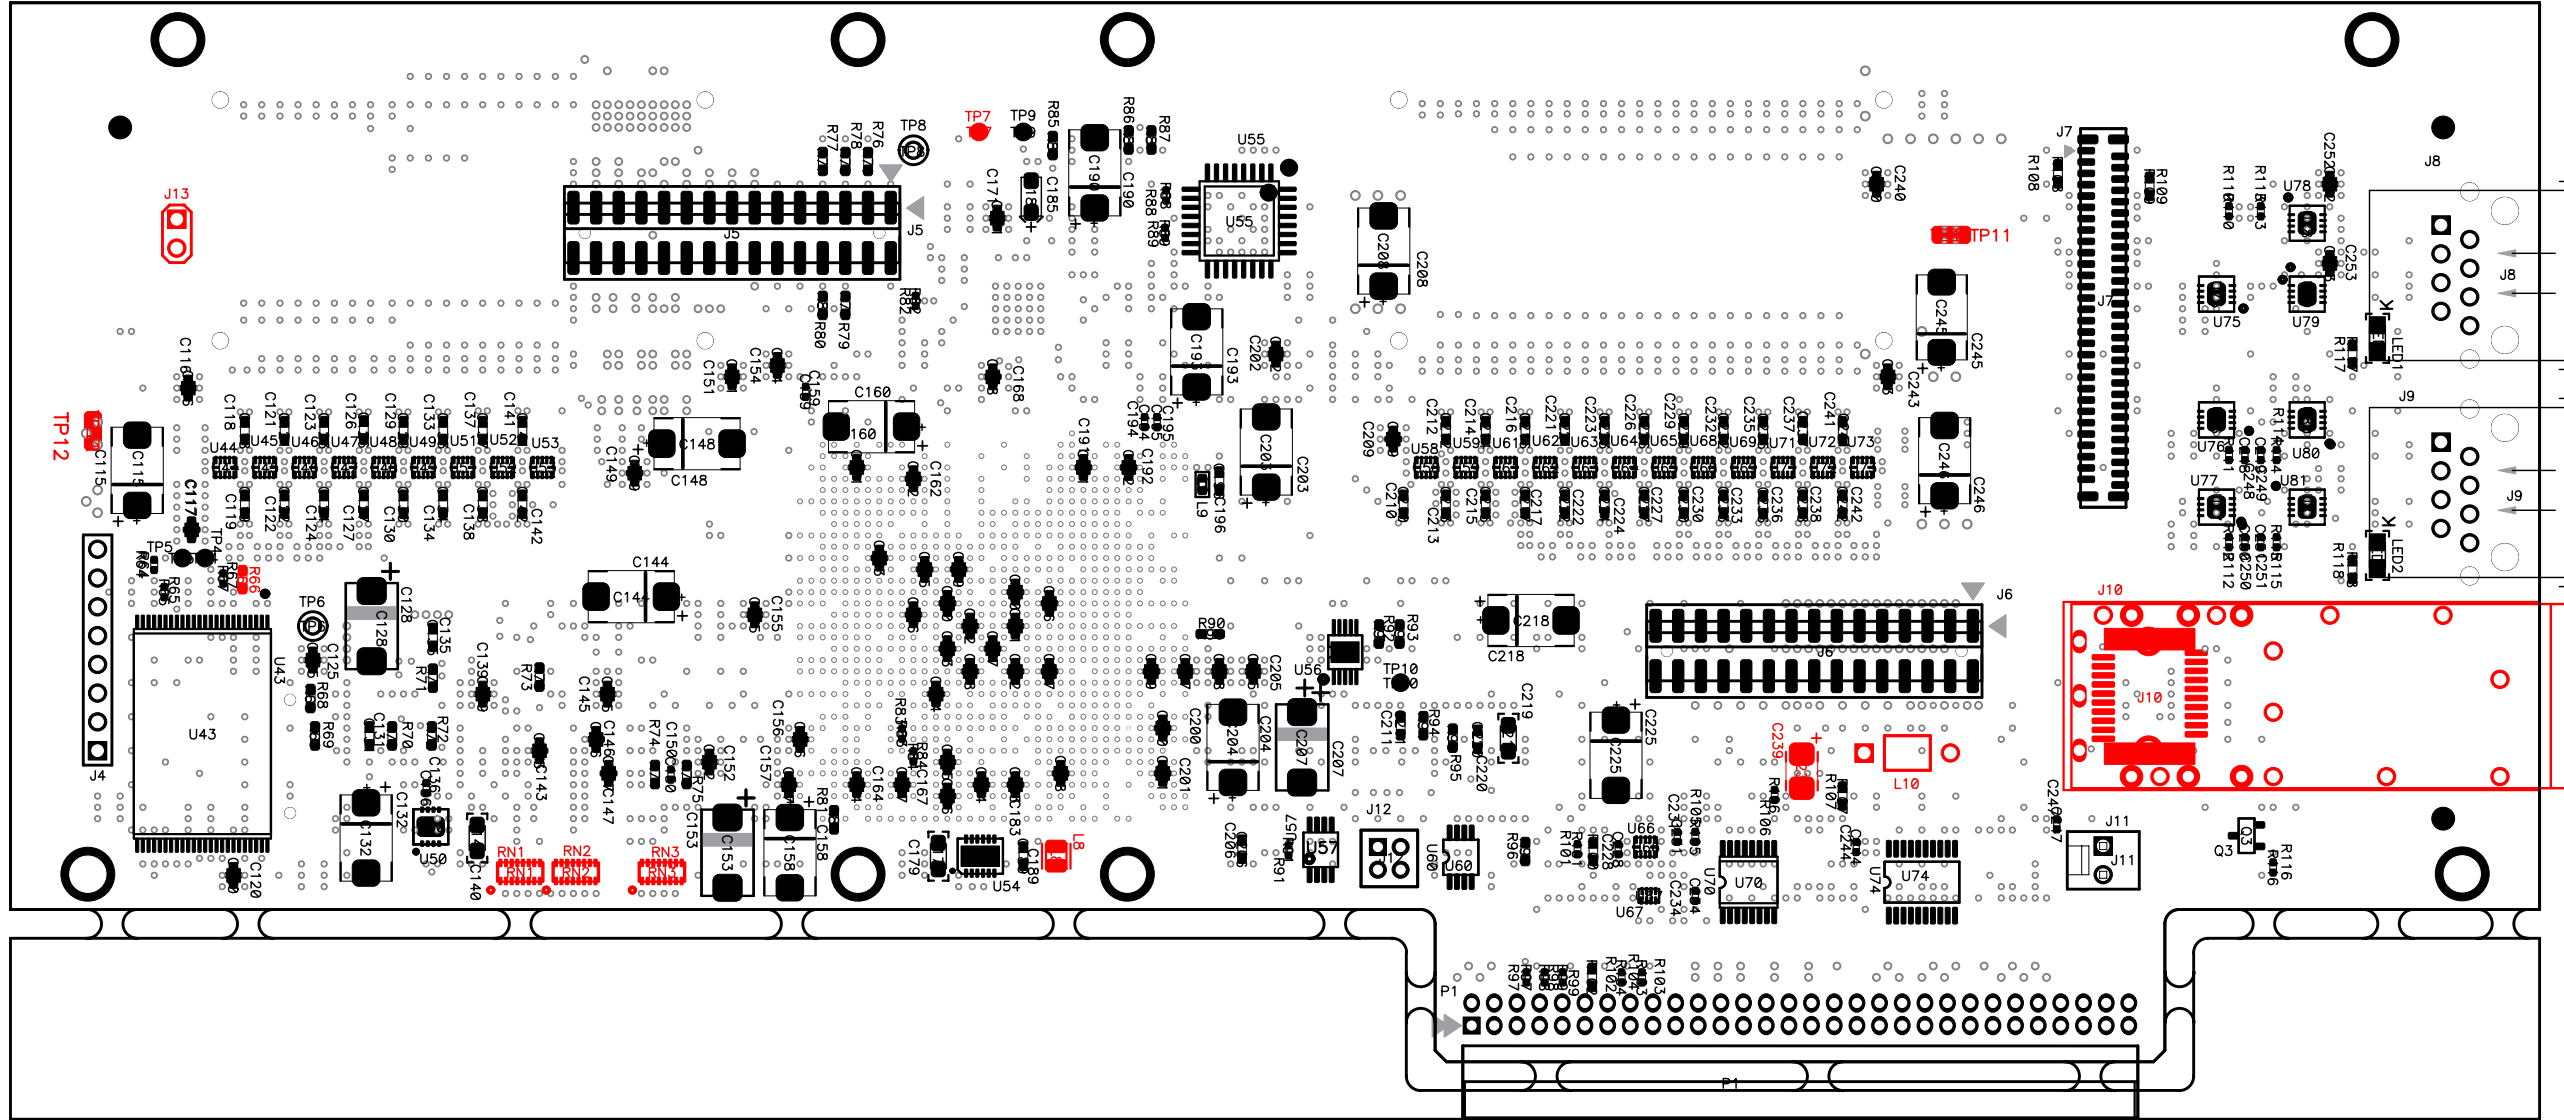

BOTTOM  
ASSEMBLY

- NOTES:
- Before installing any components check all boards using an ohm meter for shorts between all power and ground nodes.
  - All polarized caps are marked with a plus (+) sign closest to the positive node.
  - Diode orientation: D2 cathode marking is heavy bar. LED1 LED2 cathode marking is letter "K".
  - All holes and lands of uninstalled components shall be kept free of solder.
  - Do not cover serial number area with vendor labels or markings. Use a blank area near board identification text for vendor label and marking placement.
  - PNP report origin
  - If modifications are performed on this board, the cleaning process should be confined to the modified areas. Do not subject the board to any all-over cleaning processes.

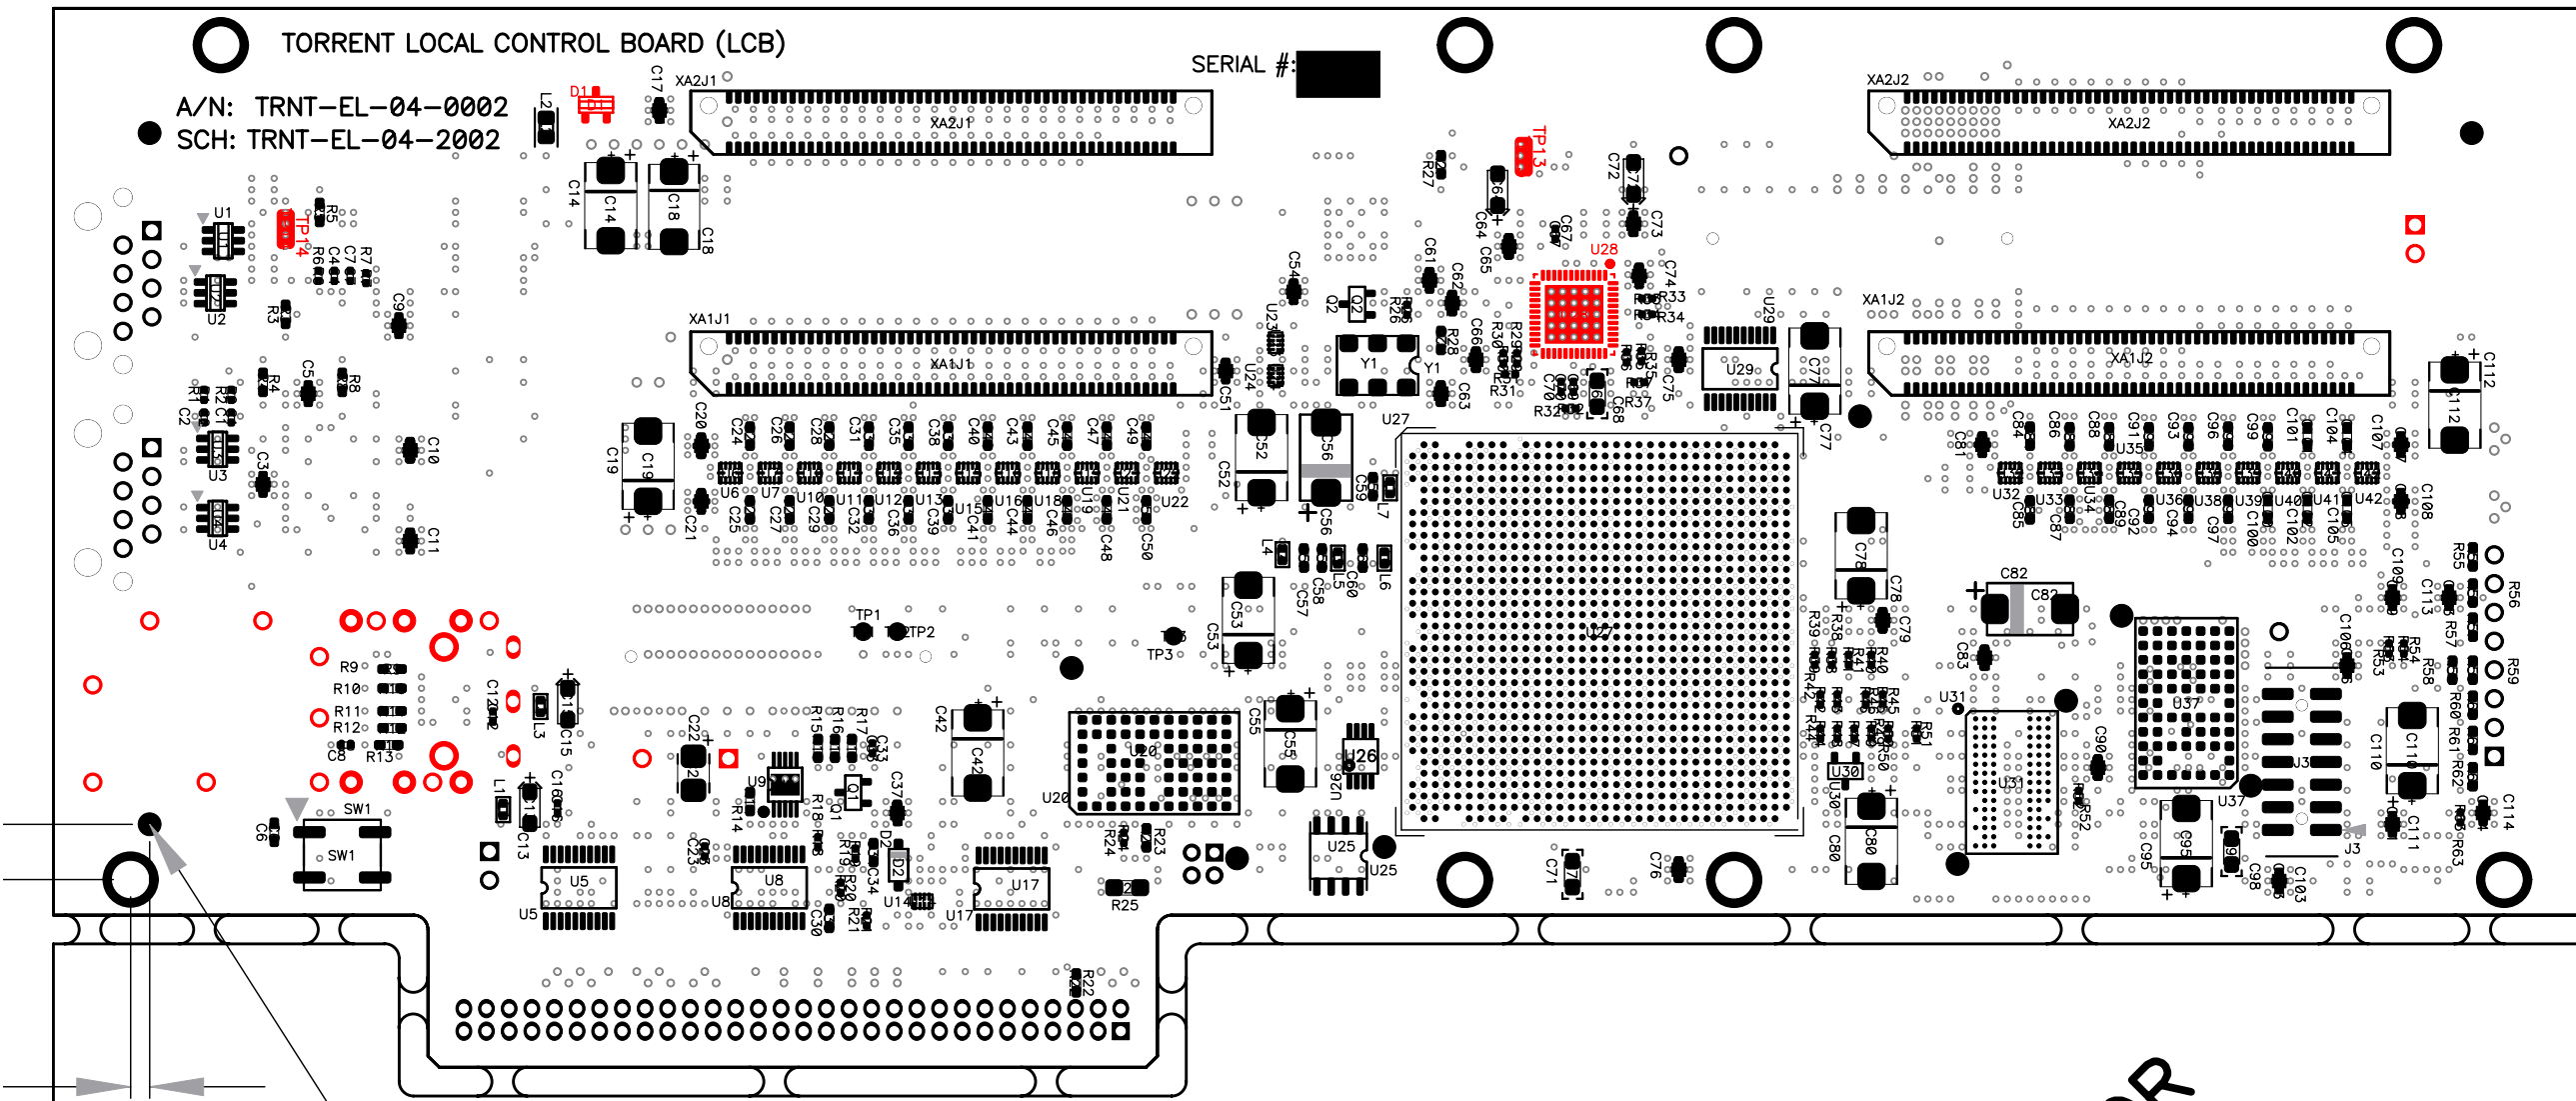

TORRENT LOCAL CONTROL BOARD (LCB)  
A/N: TRNT-EL-04-0002  
SCH: TRNT-EL-04-2002

SERIAL #


0,0 origin for PNP data

TOP  
ASSEMBLY

APPROVED FOR  
CONSTRUCTION  
03-24-09  
Modified Date: Mon Jul 27, 2009

VENDOR NOTE: NOTIFY NOAO OF ANY CONFLICTING REQUIREMENTS OR IF BOARDS CANNOT BE MANUFACTURED TO MEET THE REQUIREMENTS, DUE TO VENDORS PROCESS AND/OR TECHNIQUES OR BECAUSE PHOTO TOOLS AND/OR SPECIFICATIONS ARE INADEQUATE.

QTY REQ'D	PART OR IDENTIFYING NO	ITEM DESCRIPTION	ITE
TOLERANCES UNLESS OTHERWISE NOTED		 THIRD ANGLE PROJECTION	<b>NATIONAL OPTICAL ASTRONOMY OBSERVATORIE</b> OPERATED BY THE ASSOCIATION OF UNIVERSITIES FOR RESEARCH IN ASTRONOMY UNDER COOPERATIVE AGREEMENT WITH NATIONAL SCIENCE FOUNDATION
.XX ± .03	ANGULAR		
.XXX ± .010	± 5°		
DO NOT SCALE DRAWING		NAME <b>ASSEMBLY LOCAL CONTROL BOARD (LCB)</b>	USED ON <b>TORRENT</b>
NEXT ASSEMBLY TRNT-EL-02-xxxx			REF TORRENT
REFER TO SCHEMATIC TRNT-EL-04-2002			DWG SIZE <b>C</b>
SCALE: FULL	DESIGNED BY Dee Stover	DATE 10MAR09	REV -1
DWG PRODUCED USING	DRAWN BY	CHECKED BY	DATE
		APPROVED BY	DATE
		RELEASED	DATE
		DWG NO <b>TRNT-EL-04-0002</b>	

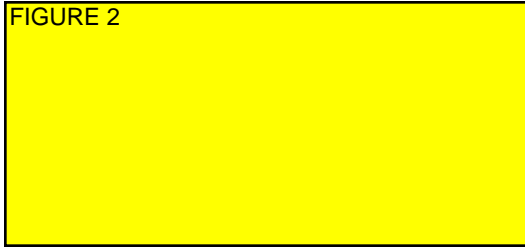


# TORRENT LOCAL CONTROL BOARD (LCB)


PN: TRNT-EL-04-1002 REV 0D

SERIAL #:


TRNT-EL-04-0002  
TRNT-EL-04-2002

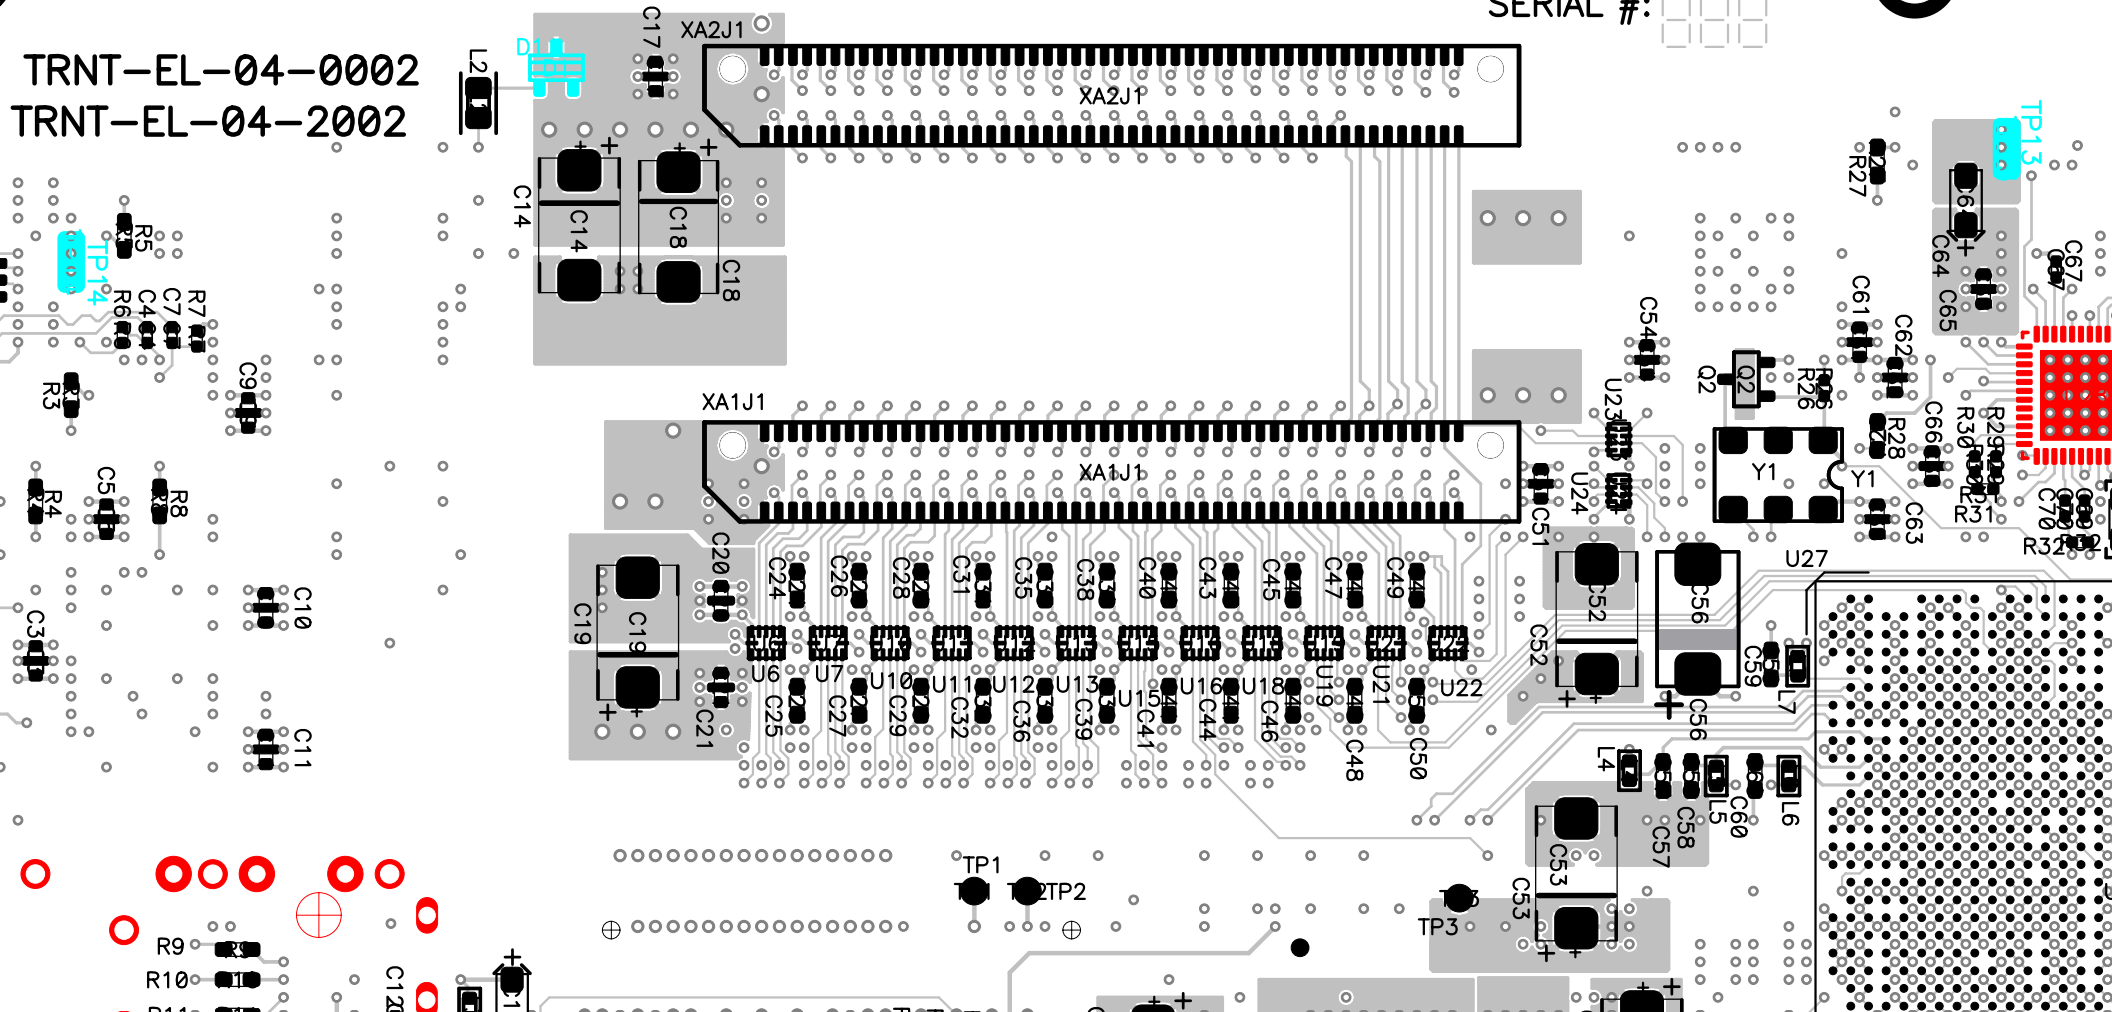

**FIGURE 3**

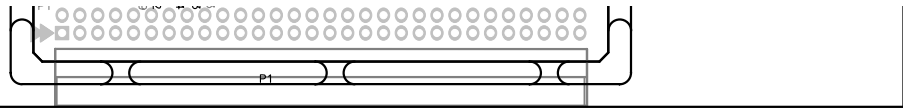

**BOTTOM  
ASSEMBLY**

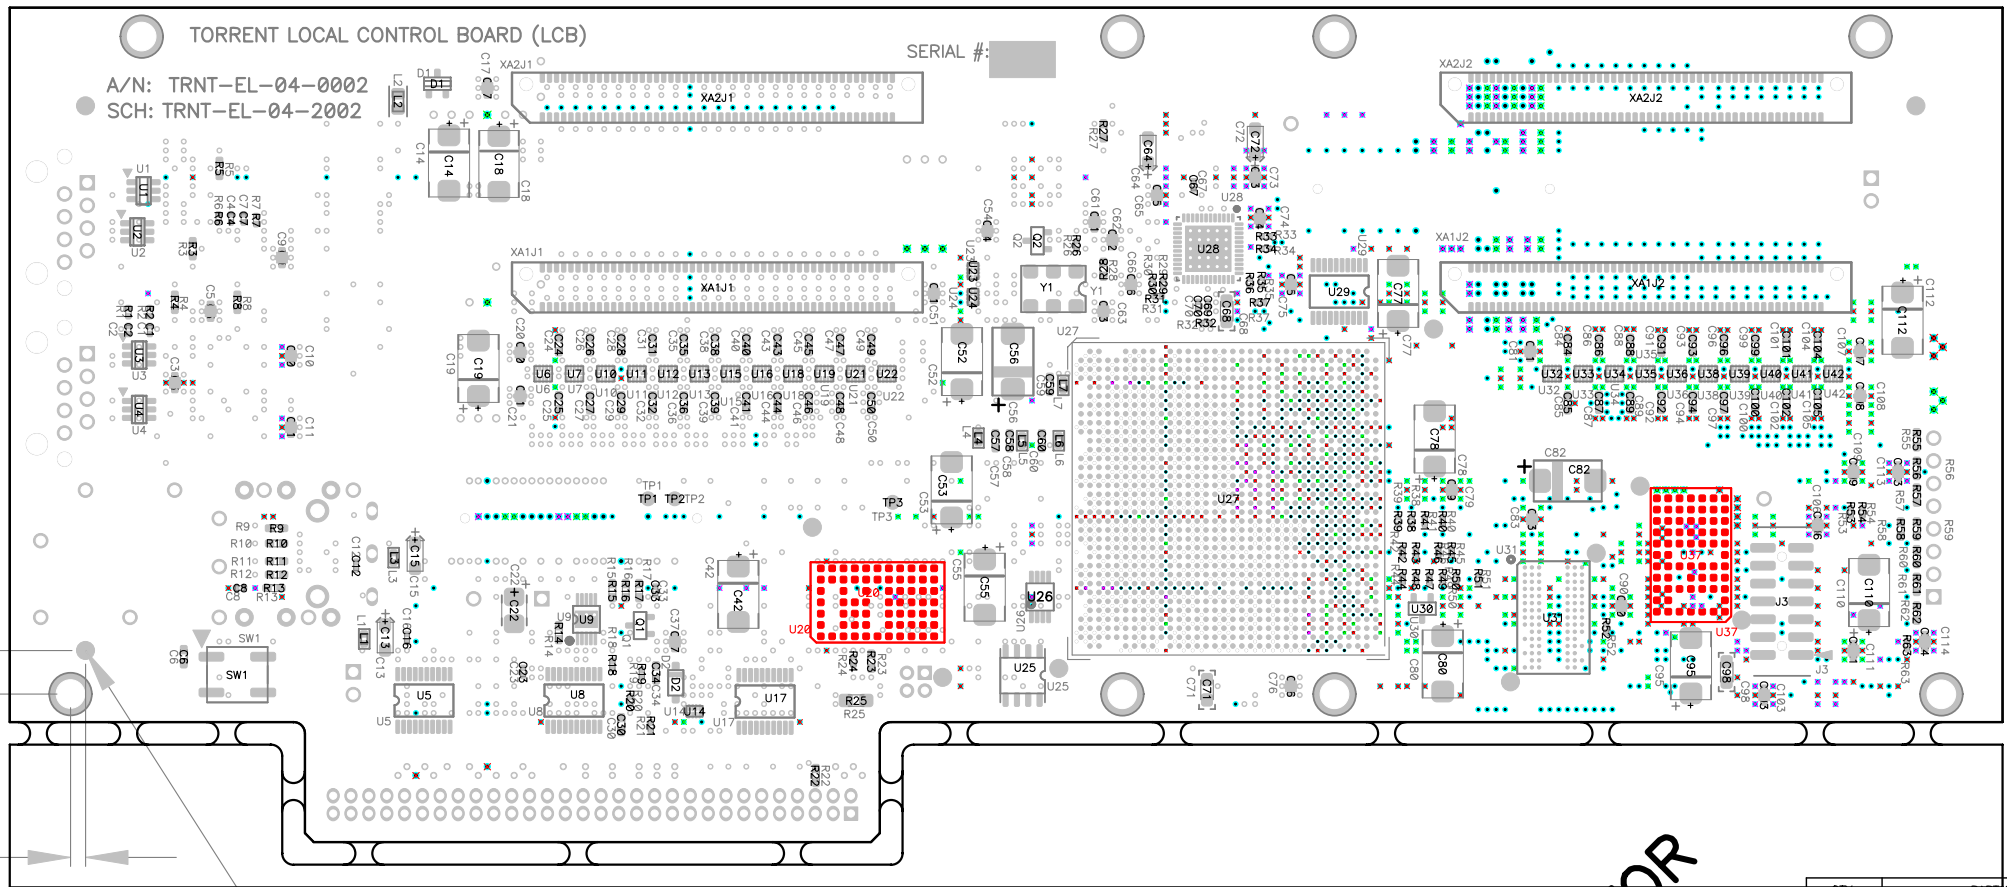

A/N: TRNT-EL-04-0002  
SCH: TRNT-EL-04-2002

TORRENT LOCAL CONTROL BOARD (LCB)

SERIAL #:

0,0 origin for PNP data

6


**TOP  
ASSEMBLY**

**APPROVED FOR  
INSTRUCTION  
4-09**

QTY REQ'D	PART OR IDENTIFYING NO
	TOLERANCES UNLESS OTHERWISE NOTED
.XX	± .03
.XXX	± .010
	DO NOT SCALE D
	NEXT ASSEMBLY TRNT-EL-02



FIGURE 3A

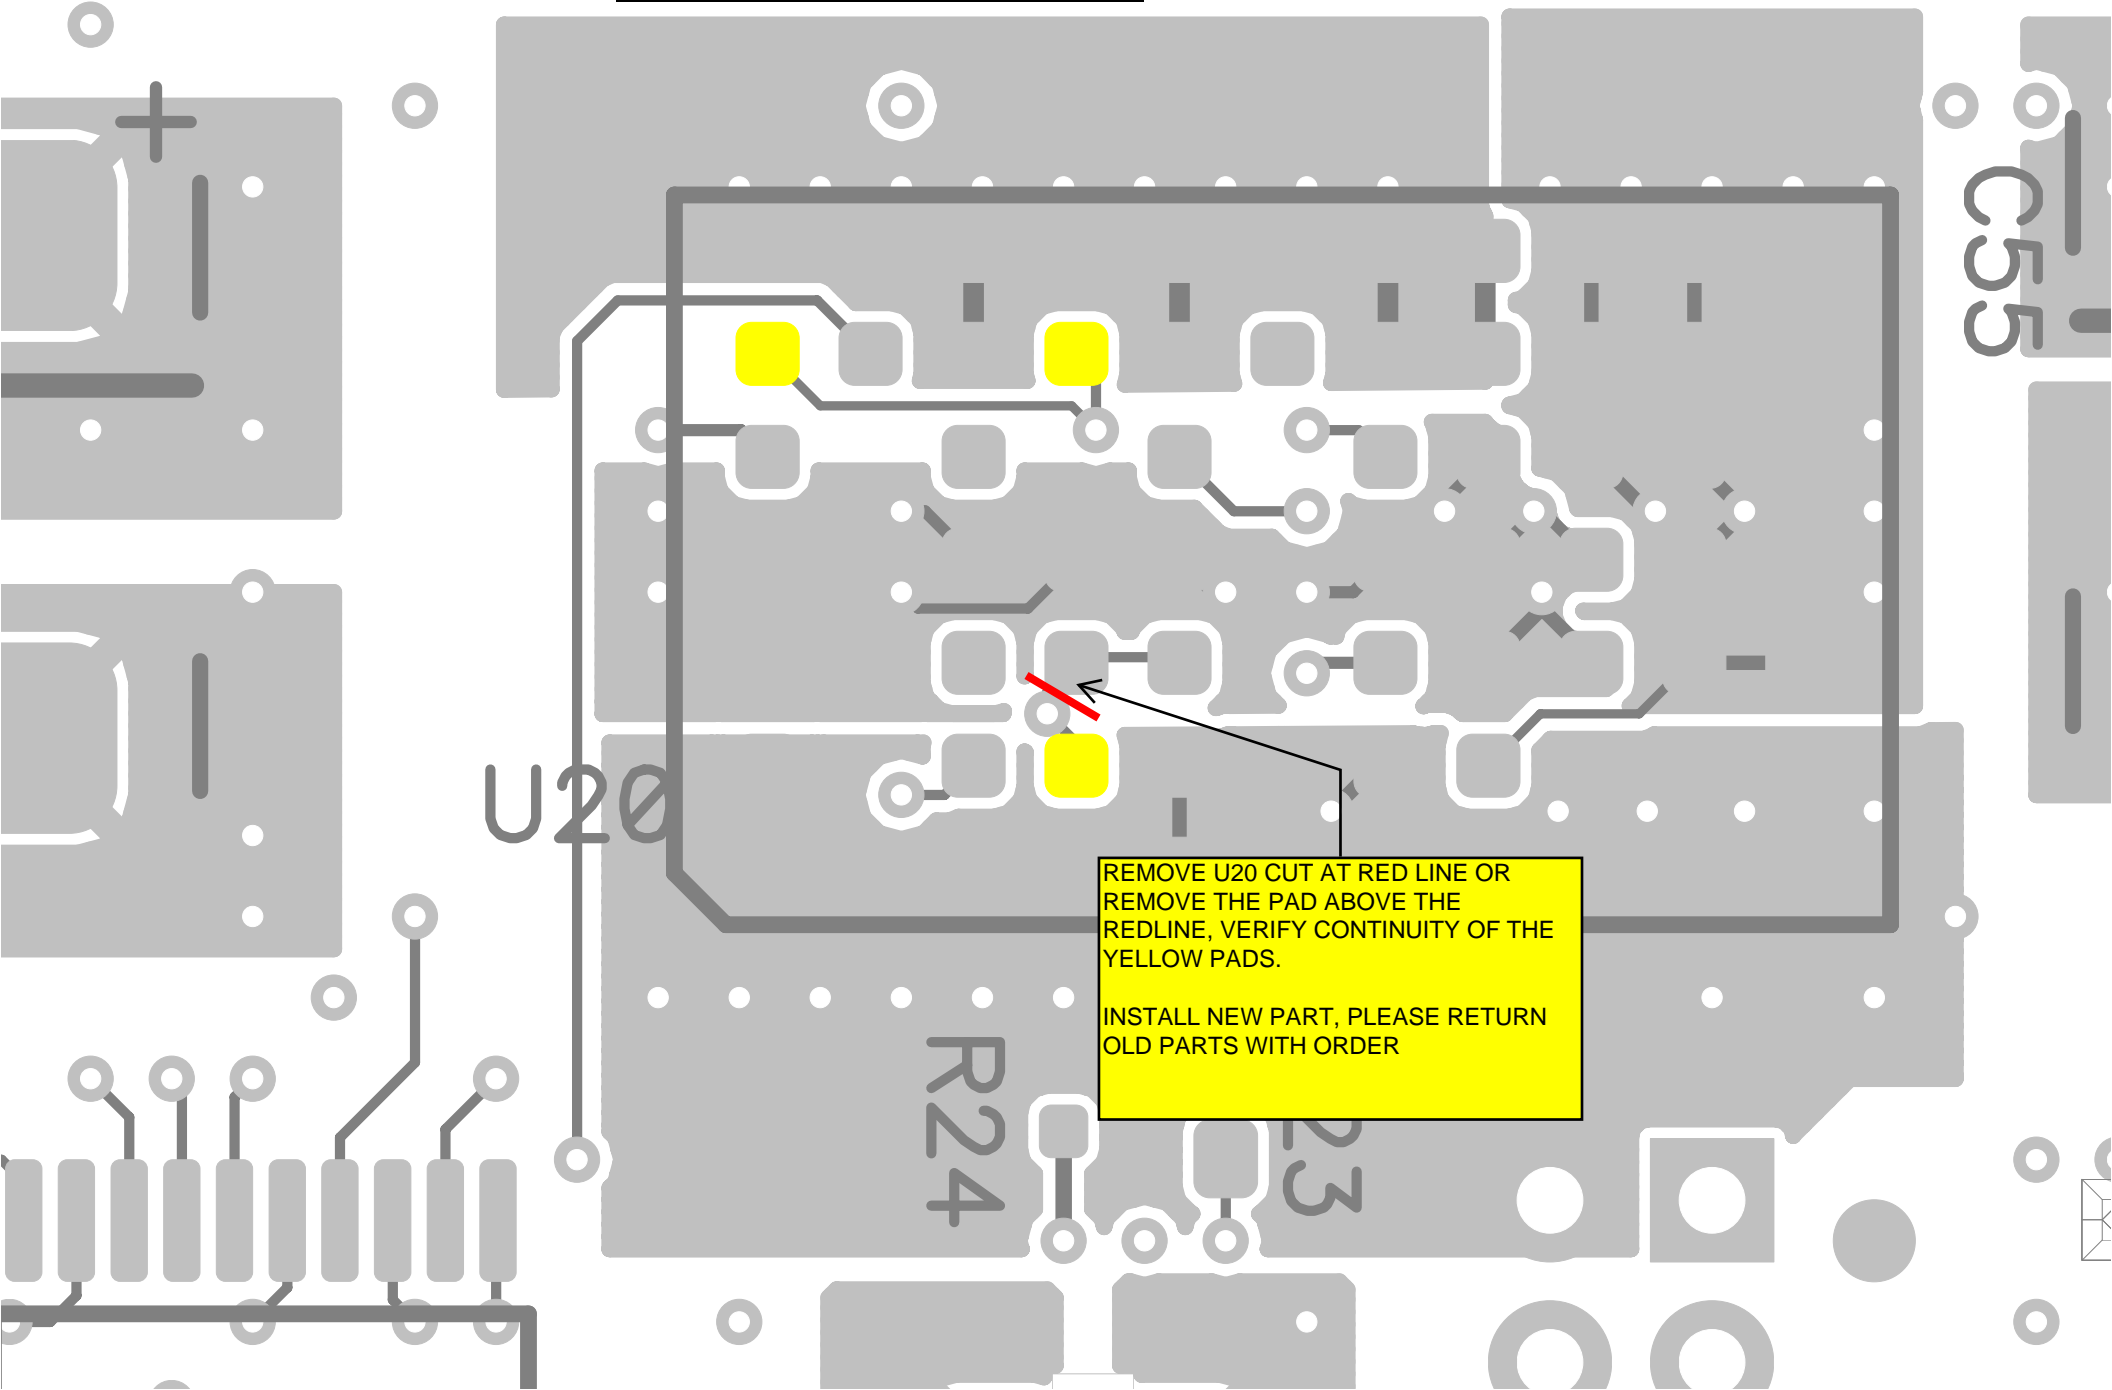


REMOVE U20 CUT AT RED LINE OR REMOVE THE PAD ABOVE THE REDLINE, VERIFY CONTINUITY OF THE YELLOW PADS.

INSTALL NEW PART, PLEASE RETURN OLD PARTS WITH ORDER



FIGURE 3B

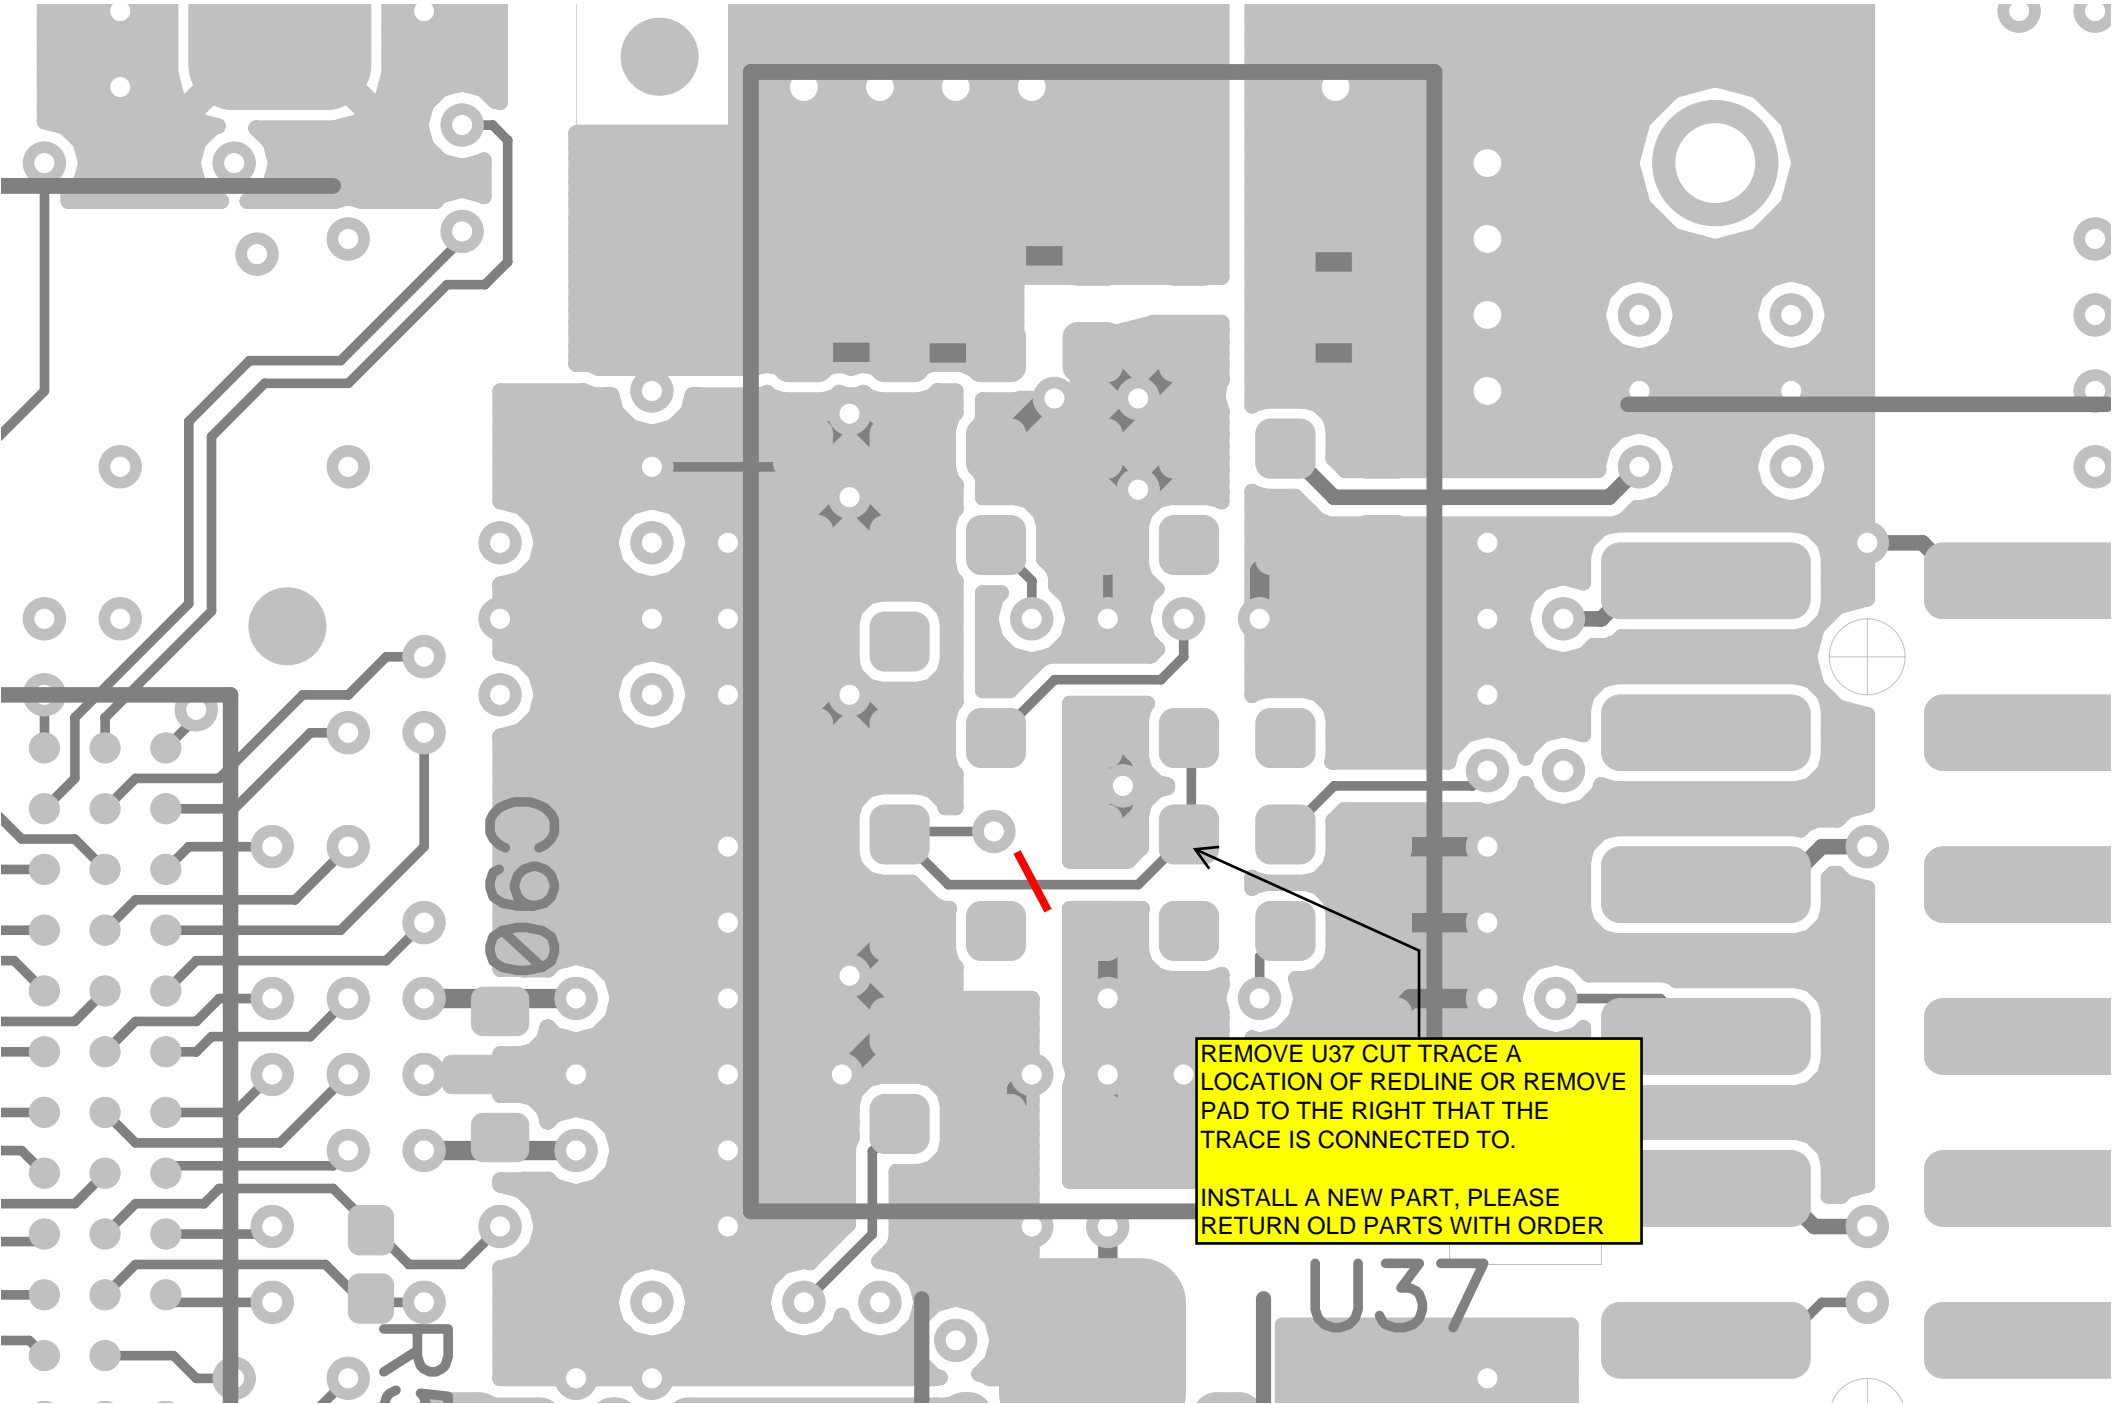

REMOVE U37 CUT TRACE A LOCATION OF REDLINE OR REMOVE PAD TO THE RIGHT THAT THE TRACE IS CONNECTED TO.

INSTALL A NEW PART, PLEASE RETURN OLD PARTS WITH ORDER

U37

FIGURE 4

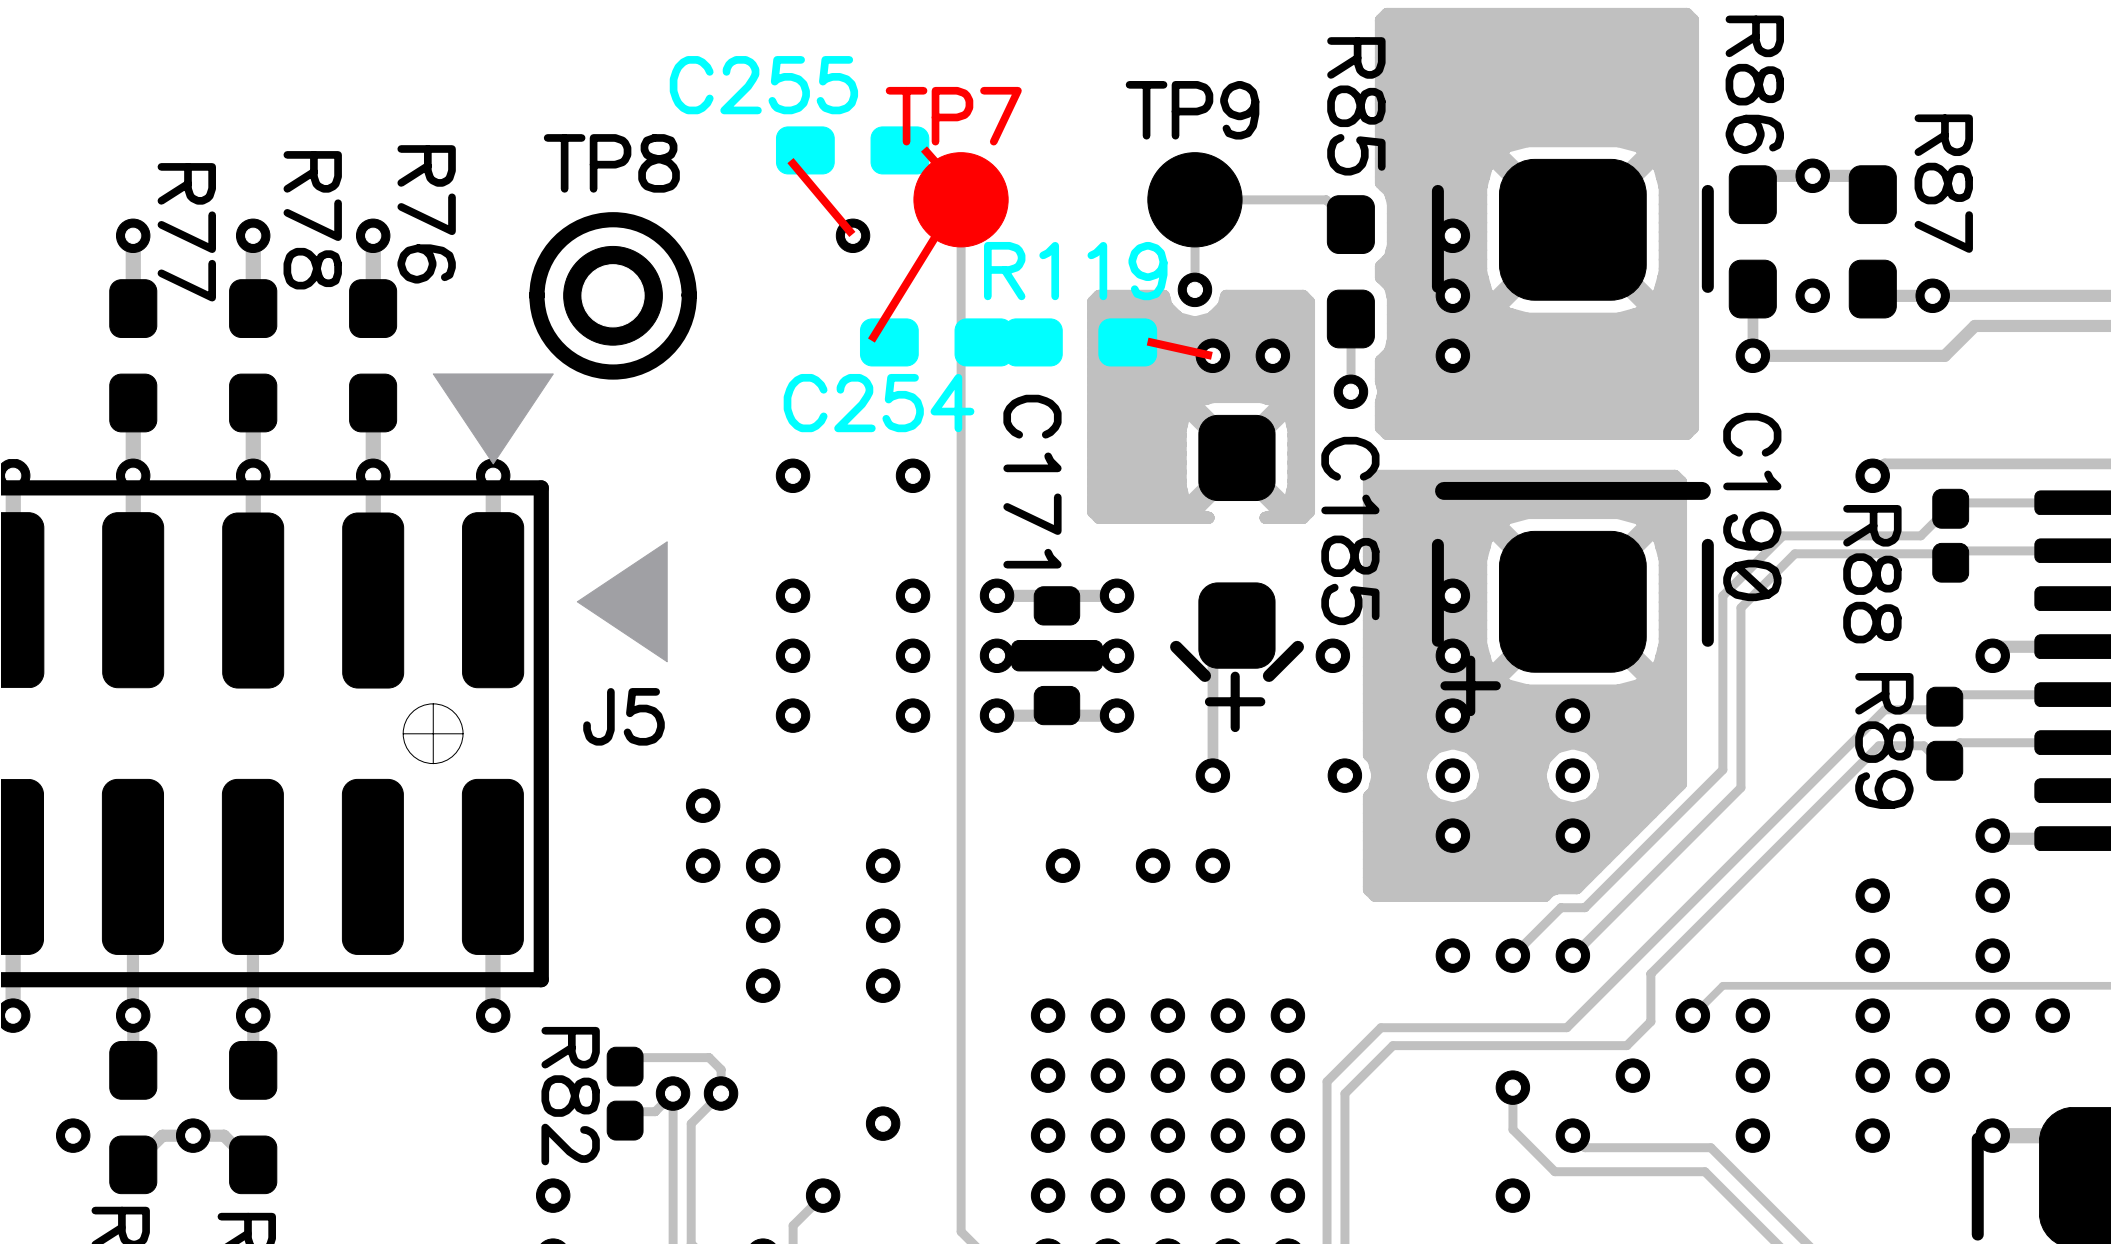








FIGURE 7