

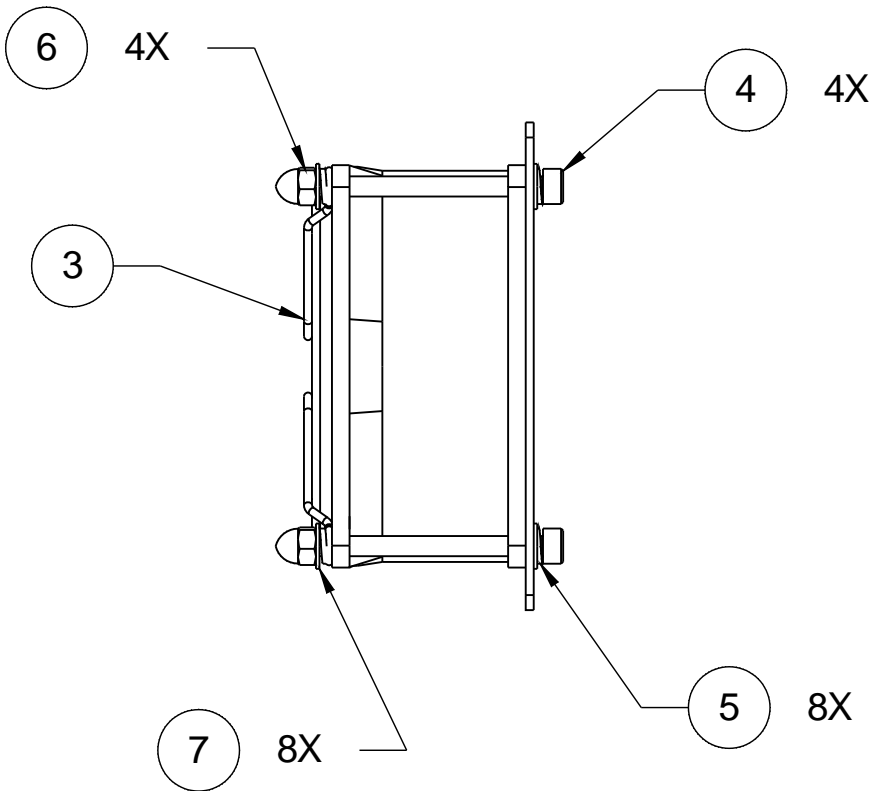


	B	CHG ASSY TO AS BUILT; REMOVED TABLE 1; ADDED "COVER" TO TITLE; CHG NEXT ASSY FROM TRNT-EL-02-0002; UPDATE P/L AS REQUIRED	MDK	1/9/2012	
	A	ADDED TABLE 1	JD	1/19/2011	
	-	INITIAL RELEASE	JD	7/23/2010	
ZONE	REV	DESCRIPTION	BY	DATE	APV BY
REVISIONS					

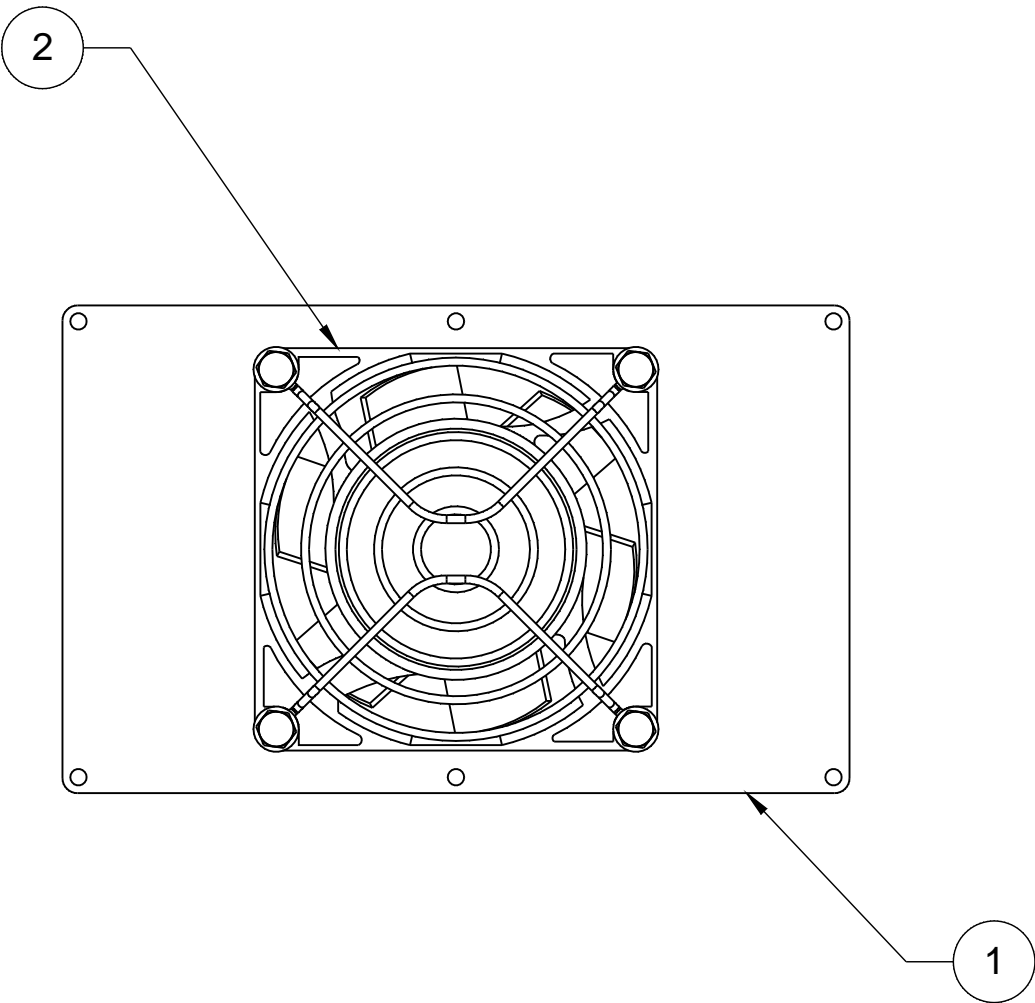

ITEM NO.	QUANTITY	MANUFACTURER	PART NO.	DESCRIPTION
1	1		TRNT-EL-02-1038	BLOWER HOUSING COVER
2	1	SOFASCO	A8038V1M	FAN, AC, 115V, 80mmX80mmX38mm
3	1	QUALTEK	8132	FAN GUARD, WIRE FORM, 80 mm
4	4			SCREW, SHC, M4x50mm L.
5	8			WASHER, LOCK, M4, 7mm OD
6	4			NUT, ACORN, M4
7	8			WASHER, FLAT, M4, 9mm OD

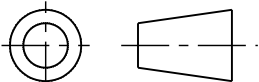

MATERIAL :								
TOLERANCES UNLESS OTHERWISE NOTED .XX ±.03 .XXX ±.010		ANGULAR ±.5°	<div></div> THIRD ANGLE PROJECTION			NATIONAL OPTICAL ASTRONOMY OBSERVATORIES OPERATED BY THE ASSOCIATION OF UNIVERSITIES FOR RESEARCH IN ASTRONOMY UNDER COOPERATIVE AGREEMENT WITH NATIONAL SCIENCE FOUNDATION		
DO NOT SCALE DRAWING		NAME BLOWER HOUSING COVER ASSEMBLY			USED ON <i>TORRENT</i>			
NEXT ASSEMBLY TRNT-EL-02-0008					DWG SIZE C	REV B		
SCALE: 2:3		DESIGNED BY: DeVRIES / RATH		CHECKED BY: XXX		DRAWING NUMBER TRNT-EL-02-0007		
DWG PRODUCED USING SOLIDWORKS 2010		DRAWN BY: DeVRIES		APPROVED BY: XXX				
				RELEASE DATE:		SHEET: 1 OF 1		

-1	
ITEM	WEIGHT (Lbs)
CALCULATED WEIGHT	